Flow Depth Map

DENVER
THE MILE HIGH CITY

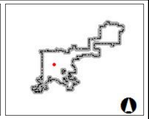

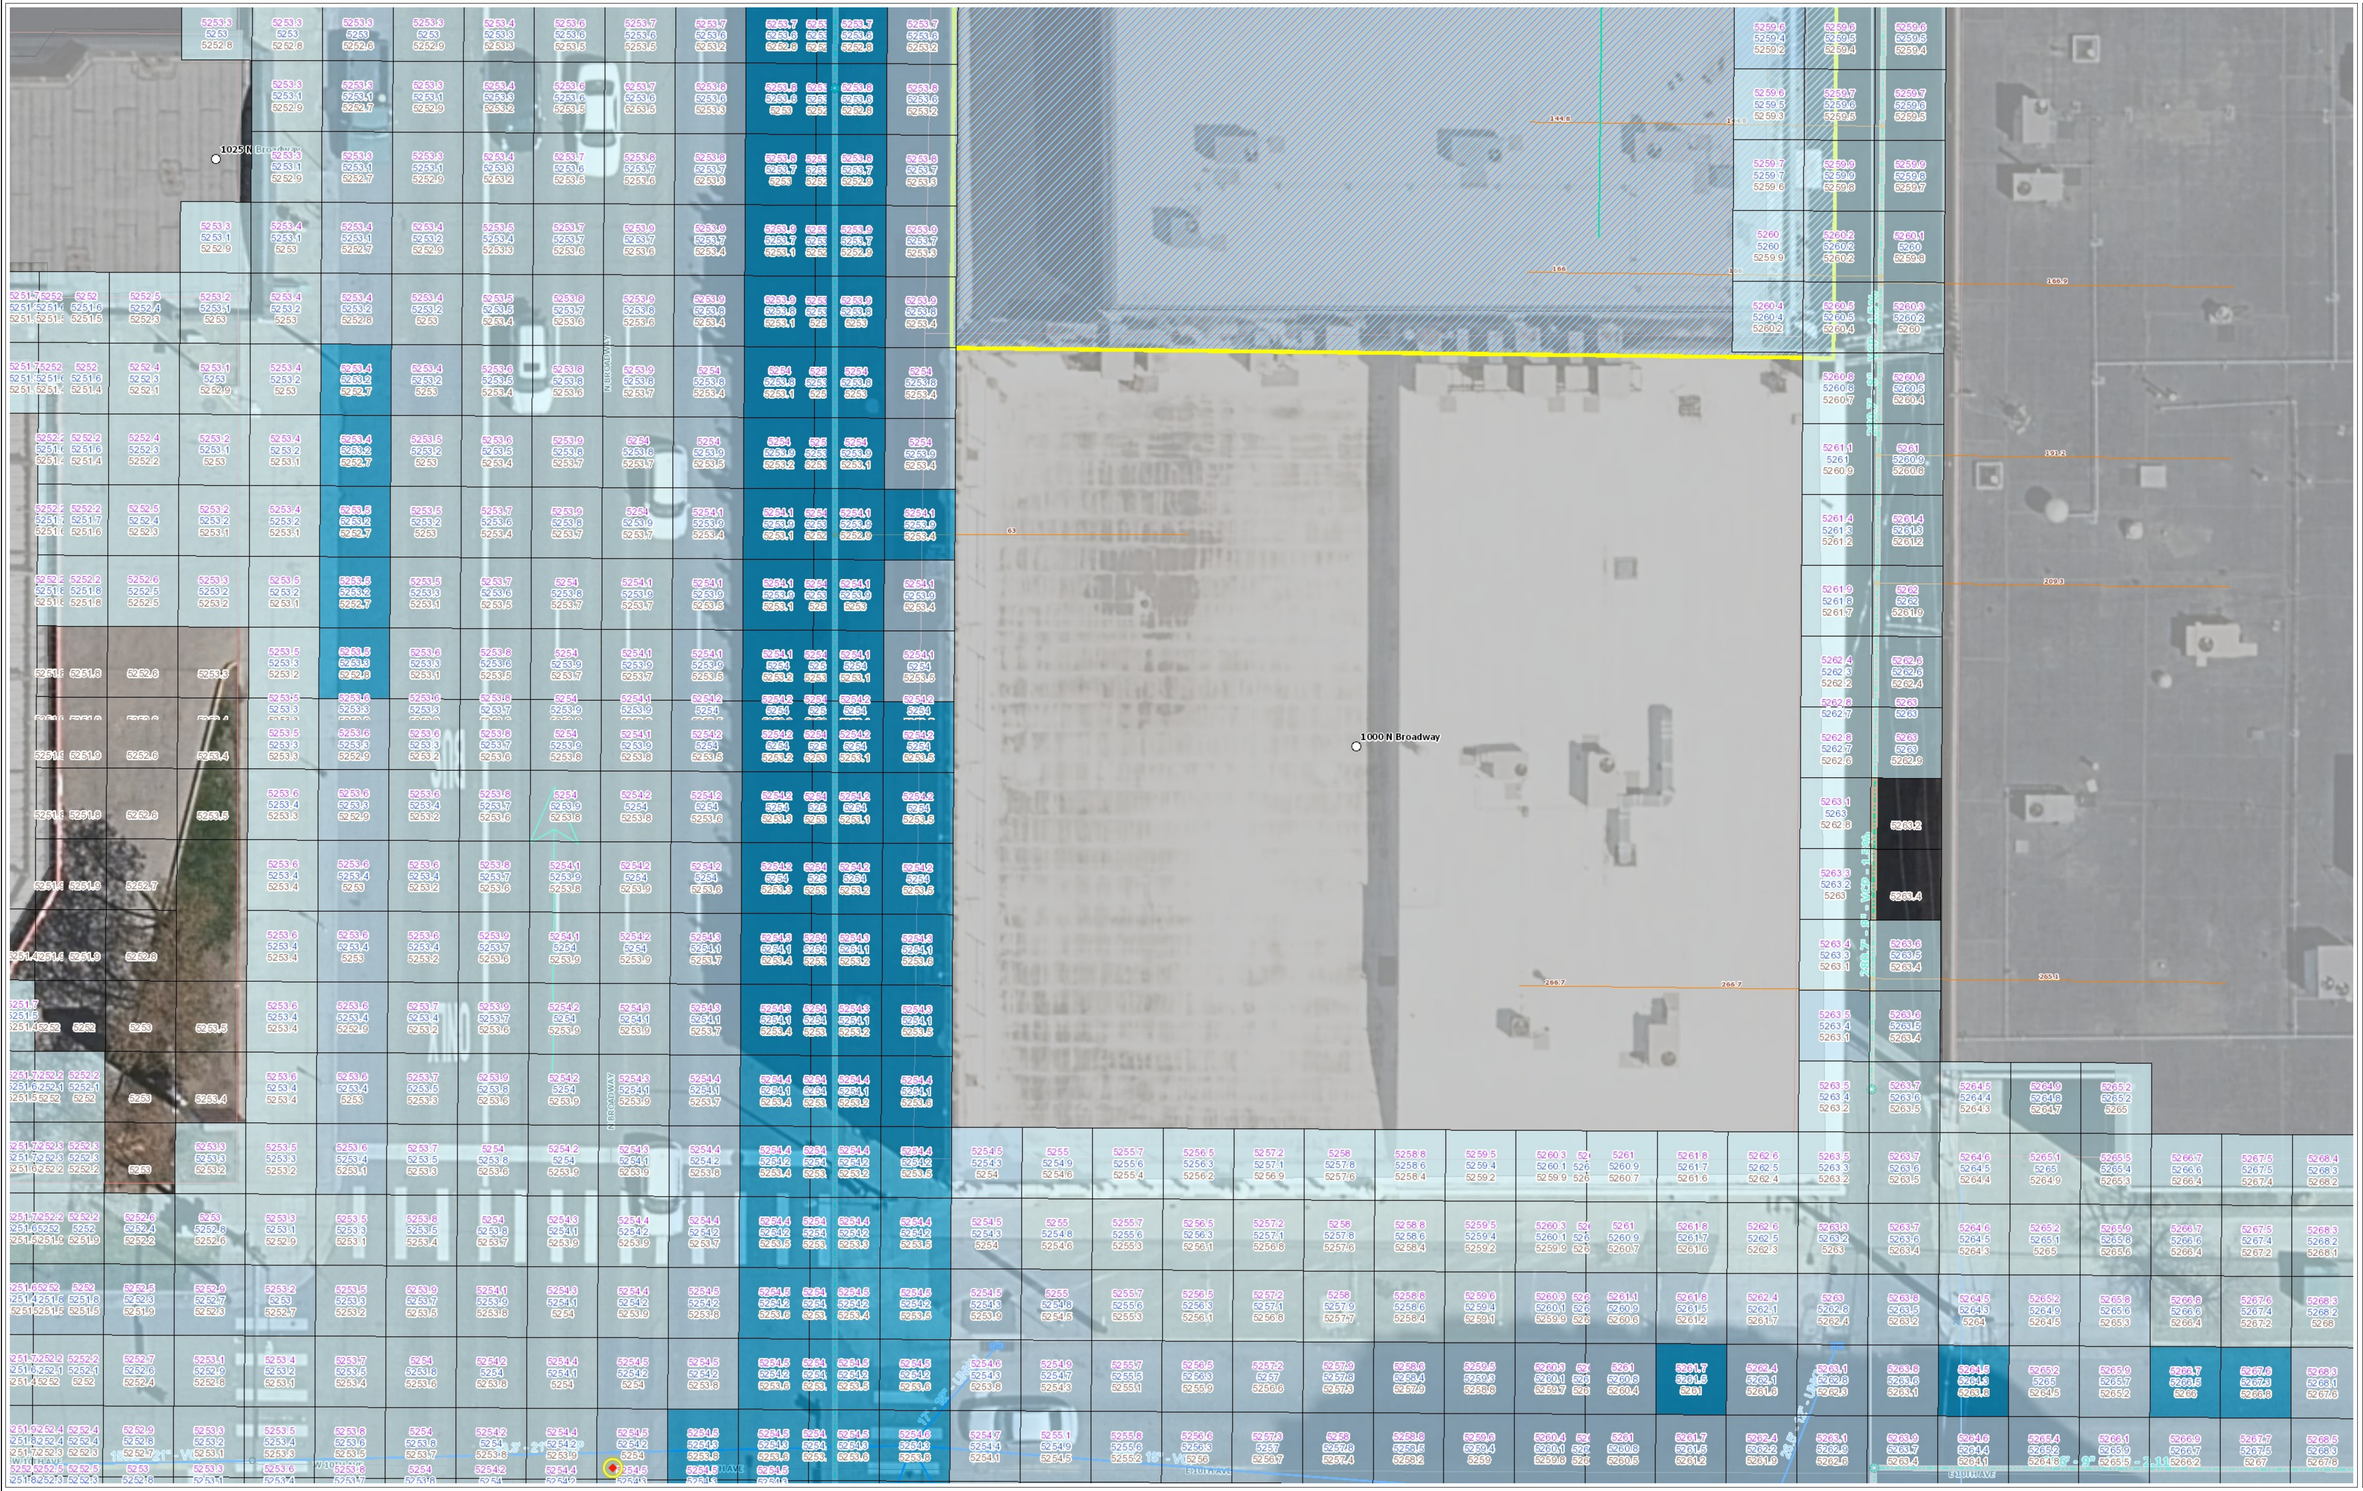

Legend

- Well Restrictions
- Barrier Restrictions
- Area Restrictions
  - Liner
  - Sheet Pile Wall Area
- Elevation Labels
- 100-Year Depth (>0")
  - <3"
  - 3" - 6"
  - 6" - 12"
  - 1' - 1.5'
  - 1.5' - 3'
  - 3' - 4.5'
  - 4.5' - 6'
  - > 6'
- Sanitary Structure
  - Cross Over Valve Vault
  - Diversion
  - Junction Chamber
  - Lift Station
  - Pump
  - Unknown
- Sanitary Cleanout
- Sanitary Fittings
  - Air/Vacuum Release Valve and Va
  - Plug Valve
  - Concentric Reducer
  - Cap
  - Connector
  - Plug
  - Tap Fitting
  - Tee
  - Unknown
- Sanitary Taps
- Sanitary Tap Distance Annotat
- Sanitary Pretreatment Facilitie:
  - AN - Acid Neutralization
  - GI - Grease Interceptor
  - IWSS - Industrial Waste Sample Sit
  - LT - Lint Trap
  - SO - Sand_Oil
  - VR - Variance
- DES Sanitary Manhole
  - DIW Manhole, Private
  - Drain Manhole, Private
  - Drop Manhole, Public
  - Drop Manhole, Private
  - Drop Manhole, Metro
  - Sanitary Manhole, Public
  - Sanitary Manhole, Private
  - Sanitary Manhole, Metro
  - Meter, Public
  - Meter, Private
- Abandoned Sanitary Manhole
- Sanitary Pipe Directional Arrov
- Sanitary Casing
- Sanitary Service Lines
- Pretreatment Service Lines
- Pretreatment Service Lines An
- Sanitary Main Annotation
- DES Sanitary Mains
  - Denver Public
  - Metro Wastewater Reclamation Dis
  - Private
  - Other
- Lined Sanitary Mains
- Abandoned Sanitary Mains
- Sanitary Easements
- Storm Fittings
  - Cap
  - Connector
  - Plug
  - Tap Fitting
  - Tee
  - Unknown
- Storm Cleanout
- Storm Structure
  - Diversion
  - Spillway
  - UV Station
  - Outlet Structure
  - Check Dam
  - Drop Structure
  - Forebay
  - Pump Station
  - Sump
  - Unknown
  - Vault
- Storm Tap Distance Annotatio
- Storm Taps
- Storm Manhole
  - Storm Meter, Public
  - Storm Manhole, Private
  - Storm Manhole, Public
- Storm Pipe Direction Arrow
- Storm Inlets
  - Unknown Inlet, Public
  - Unknown Inlet, Private
  - Other, Public
  - Other, Private
  - Grated Inlet, Public
  - Grated Inlet, Private
  - Curb Opening Inlet, Public
  - Curb Opening Inlet, Private
  - Combination Inlet, Public
  - Combination Inlet, Private
- Storm Outfall
  - Flared End Section

20 0 10 20 Feet

WGS_1984_Web_Mercator_Auxiliary_Sphere
© City and County of Denver

1: 158

Map Generated: 4/26/2022

The City and County of Denver shall not be liable for damages of any kind arising out of the use of this information. The information is provided "as is," without warranty of any kind, express or implied, including, but not limited to, the fitness for a particular use.
THIS IS NOT A LEGAL DOCUMENT.

5281.6 2 x 100 - Year Maximum WSEL at Cell Grid
5280.5 100 - Year Maximum WSEL at Cell Grid
5279.1 Ground Elevation at Cell Grid