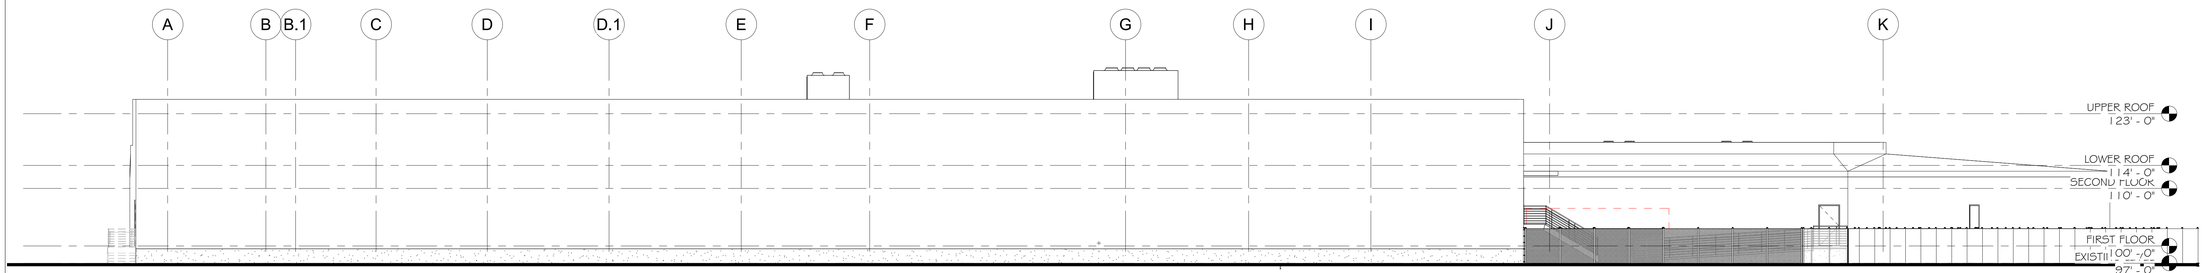

1 North
3/32" = 1'-0"

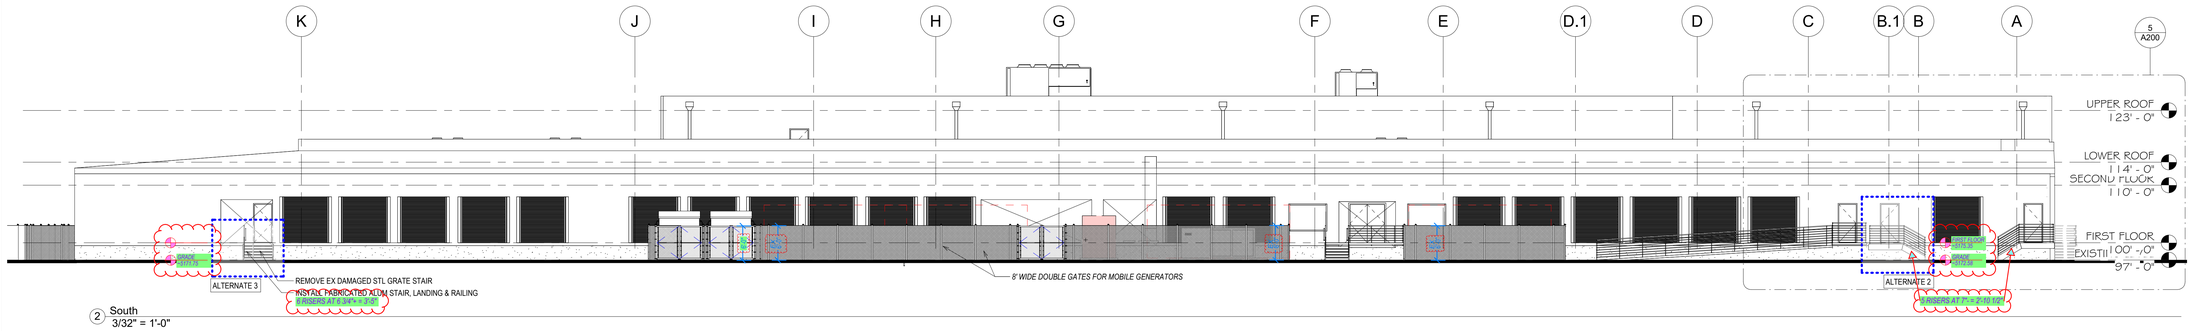

2 South
3/32" = 1'-0"

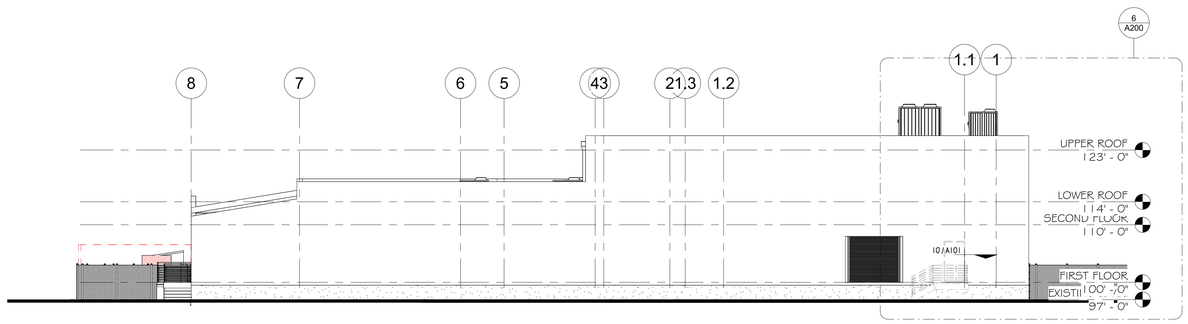

3 East
3/32" = 1'-0"

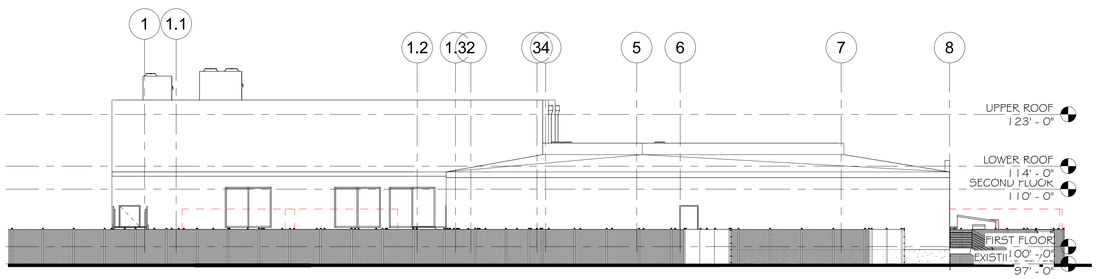

4 West
3/32" = 1'-0"

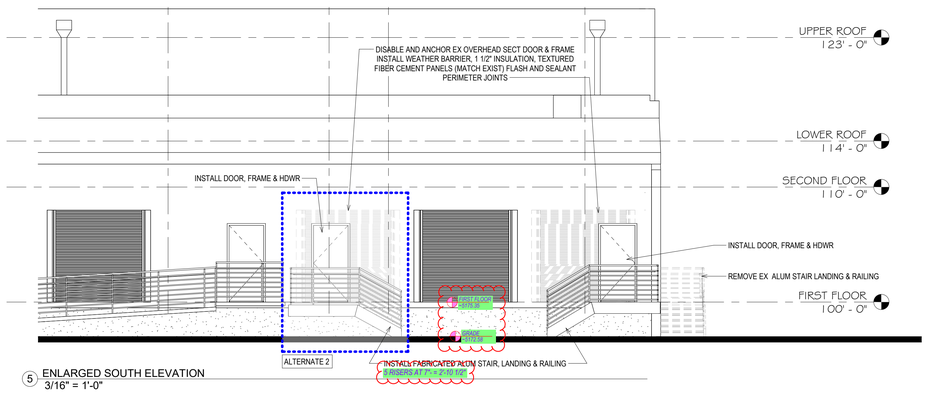

5 ENLARGED SOUTH ELEVATION
3/16" = 1'-0"

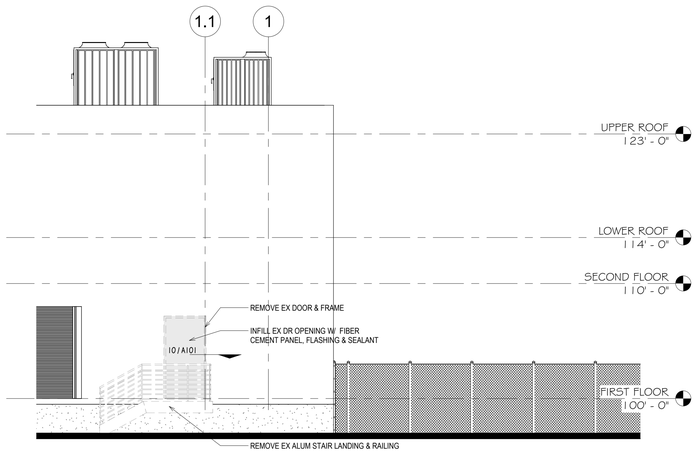

6 ENLARGED EAST ELEVATION
3/16" = 1'-0"

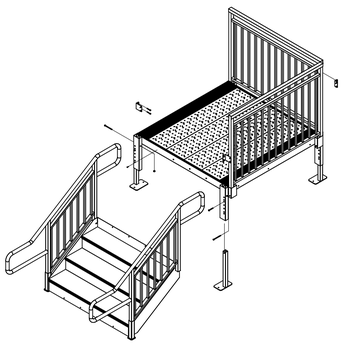

7 FABRICATED ALUM STAIR, LANDING & RAILING DETAILS
3/8" = 1'-0"

OLC
2000 LAWRENCE STREET
DENVER, COLORADO 80205
T: 303.294.9244
www.olcdesigns.com

STATE OF COLORADO
DANA R. POTTER
201530
LICENSED ARCHITECT

Crossroads Renovation
1901 29TH STREET, DENVER, COLORADO 80216

NO.	DATE:	TITLE/PURPOSE:
	04.16.2025	SD PHASE
	05.16.2025	DD PHASE
	07.15.2025	95% CD
	08.01.2025	PERMIT SET

SCALE: As indicated
ISSUE DATE: 08/01/2025
DRAWN BY: Author
REV'D BY: Checker
PROJECT #: 23110
TITLE: EXTERIOR ELEVATIONS
SHEET #: A200

© 2024 OLC
8/3/2025 11:56:41 AM
Autodesk Docs://23110-Homeless Shelters_R24\23110_Crossroads Renovation-1901 29th St-V24.rvt