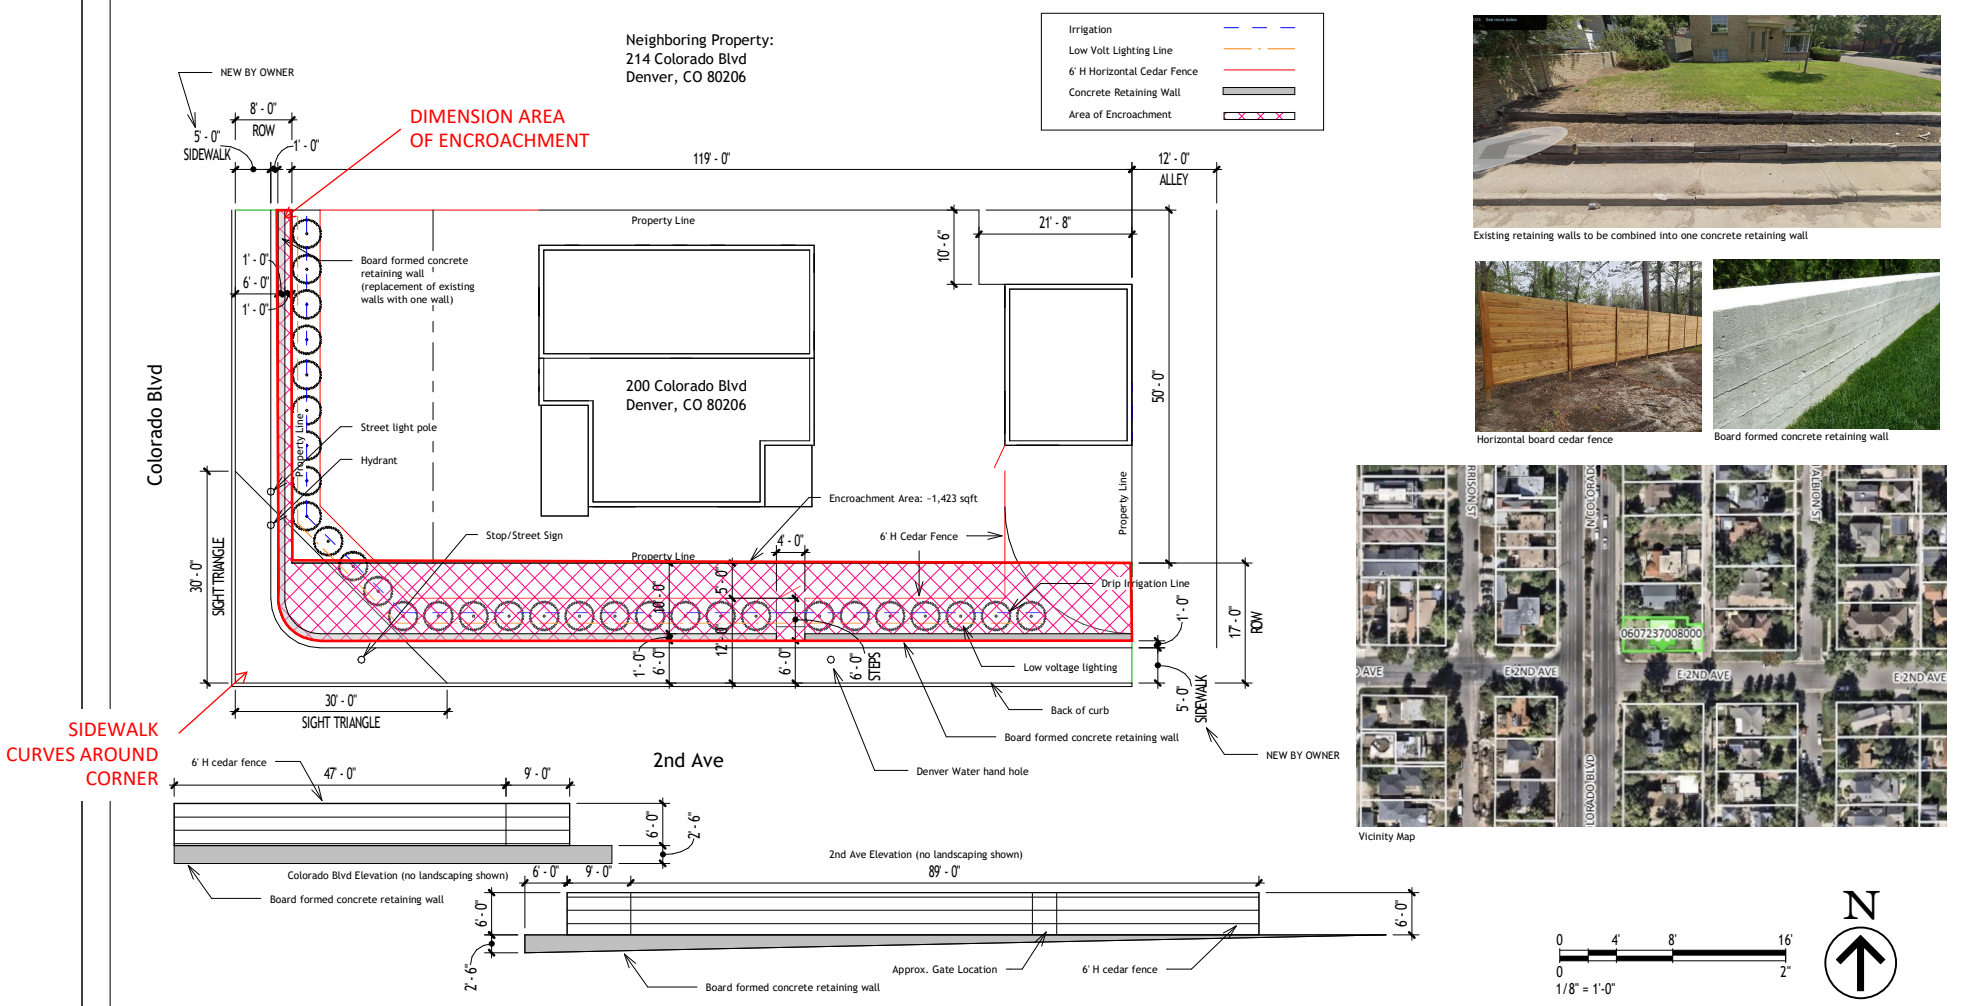

200 COLORADO BLVD DENVER, CO 80206

DOTI ENCROACHMENT PLAN

No.	Description	Date

ENCROACHMENT PLAN

Project number	200CB
Date	12/29/2025
Drawn by	TL
Checked by	TL

DOTI

Scale 1/16" = 1'-0"

1/2/2026 8:39:11 AM